



**GENERAL ARRANGEMENT
SCALE 1:200**

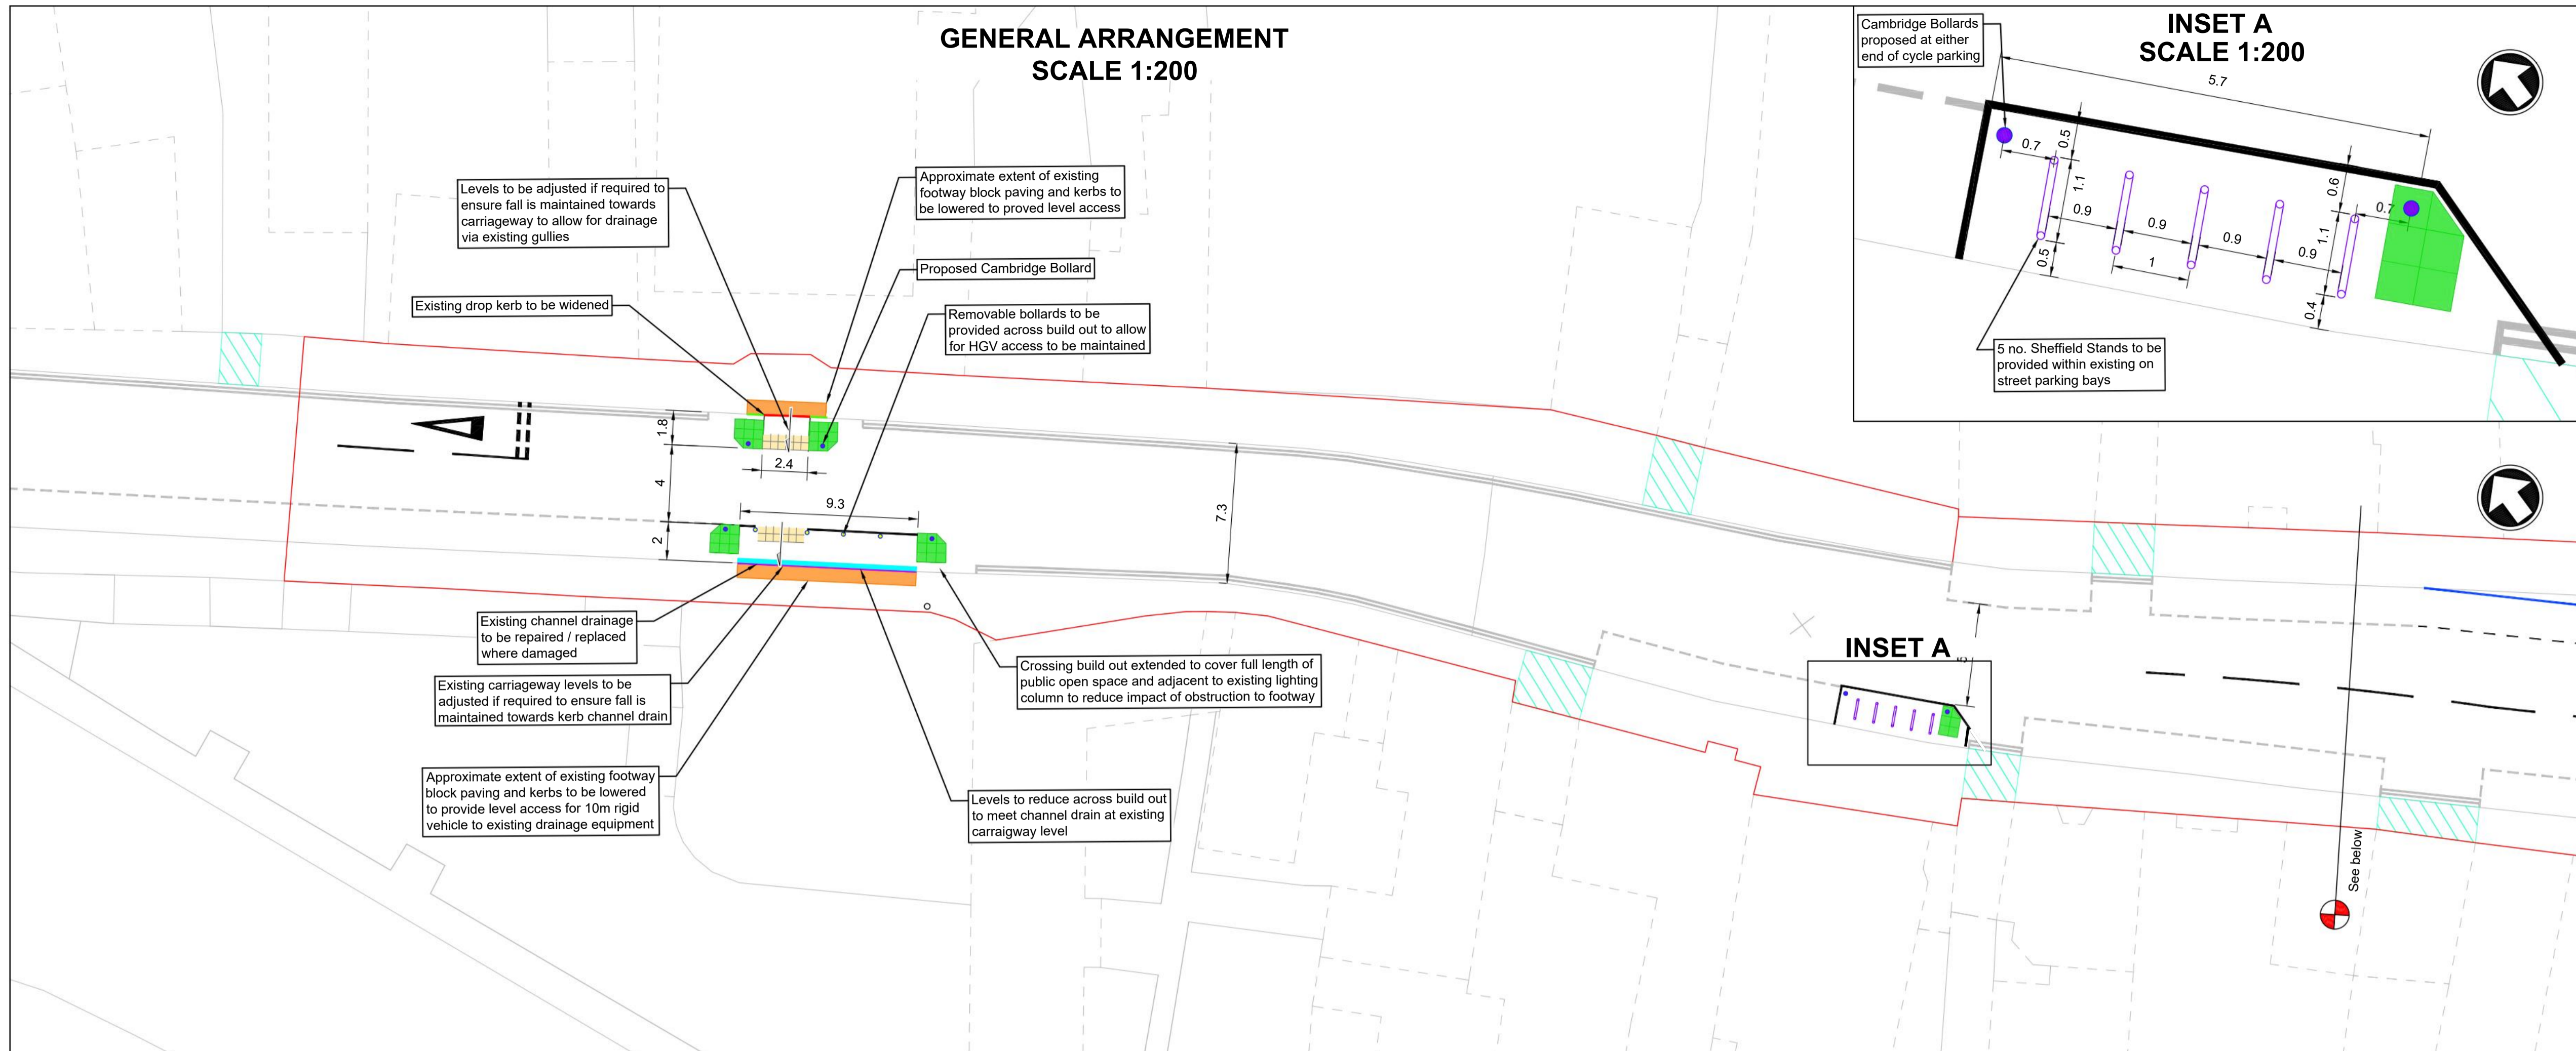

**INSET A
SCALE 1:200**

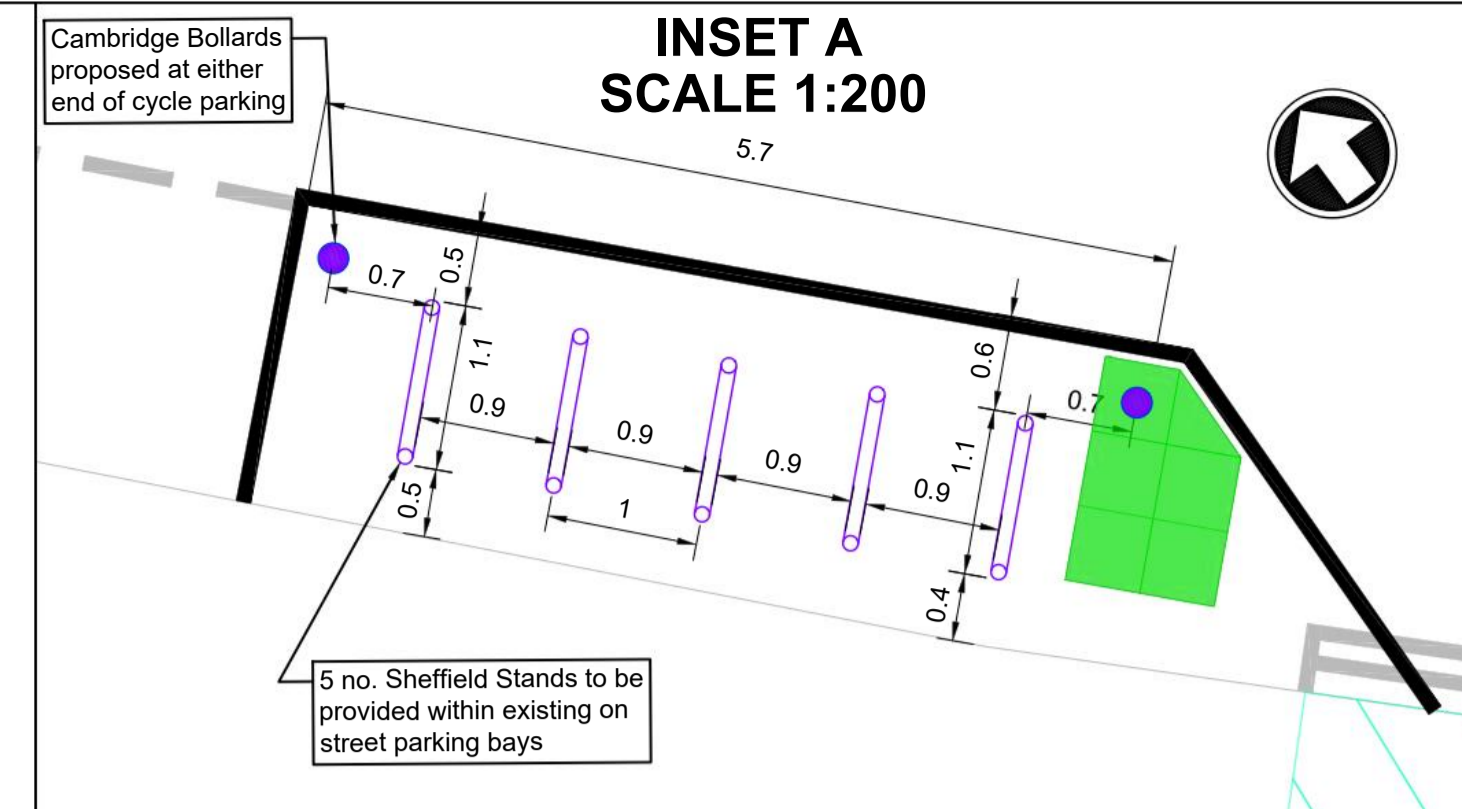

- Notes
- Do not scale from this drawing
 - The proposed design is based on available OS mapping only
 - The setting out dimensions shall be verified on site with any discrepancies reported to Mott MacDonald prior to proceeding
 - Where existing road markings and street furniture are shown, they are indicative and for the purposes of illustrating proposed design arrangements only. If the existing arrangement does not reflect the actual arrangement on site, the Contractor shall inform Mott MacDonald team for further review prior to installation
 - Utility investigation has not been undertaken during the development of the design. The Contractor shall obtain utility records and undertake appropriate site surveys prior any excavation works.

- Key to symbols
- Planter (1m x 1m)
 - Cycle Racks x 3 (1m x 2m)
 - Picnic Table (1.5m x 2m)
 - Bench (0.75m x 2m)


- Key to symbols
- Proposed Road Markings
 - Existing Features
 - Proposed upstand kerb
 - Proposed transition kerb
 - Proposed flush (dropped) kerb
 - Existing drainage gully
 - Proposed gully with 'Nib Nobbler' drainage channel Gully as per HERCS Standard Channel drain as per Aco Multidrain
 - Existing footway property drain connection
 - Proposed footway / island (see Standard Detail 105C)
 - Existing dropped kerb / vehicle crossover
 - Proposed Redipave traffic island (or equivalent approved) (see Standard Detail 108B)
 - Proposed footway / carriageway reconstruction
 - Proposed blister (buff) tactile paving (see Standard Detail 108A&C)
 - Proposed removable Cambridge bollard
 - Proposed fixed Cambridge bollard
- Gradient 1:80 to 1:40 range, except at crossings, where 1:20 permitted locally as per plan.

Location Plan - Scale 1:5000



P7 Markup - 13/02/2023 Planters and street furniture added

Rev	Date	Drawn	Description	Ch'k'd	App'd
P6	11/08/22	KZ	Detailed design for costing	CK	OD
P5	21/04/22	KZ	Priority arrangement amended on The Waits	CK	OD
P4	11/04/22	KZ	Cycle parking location and parking numbers amended	CK	OD
P3	20/01/22	DR	CCC comments incorporated	CK	OD
P2	17/01/22	DR	CCC comments incorporated	CK	OD
P1	12/01/22	DR	First issue	CK	OD

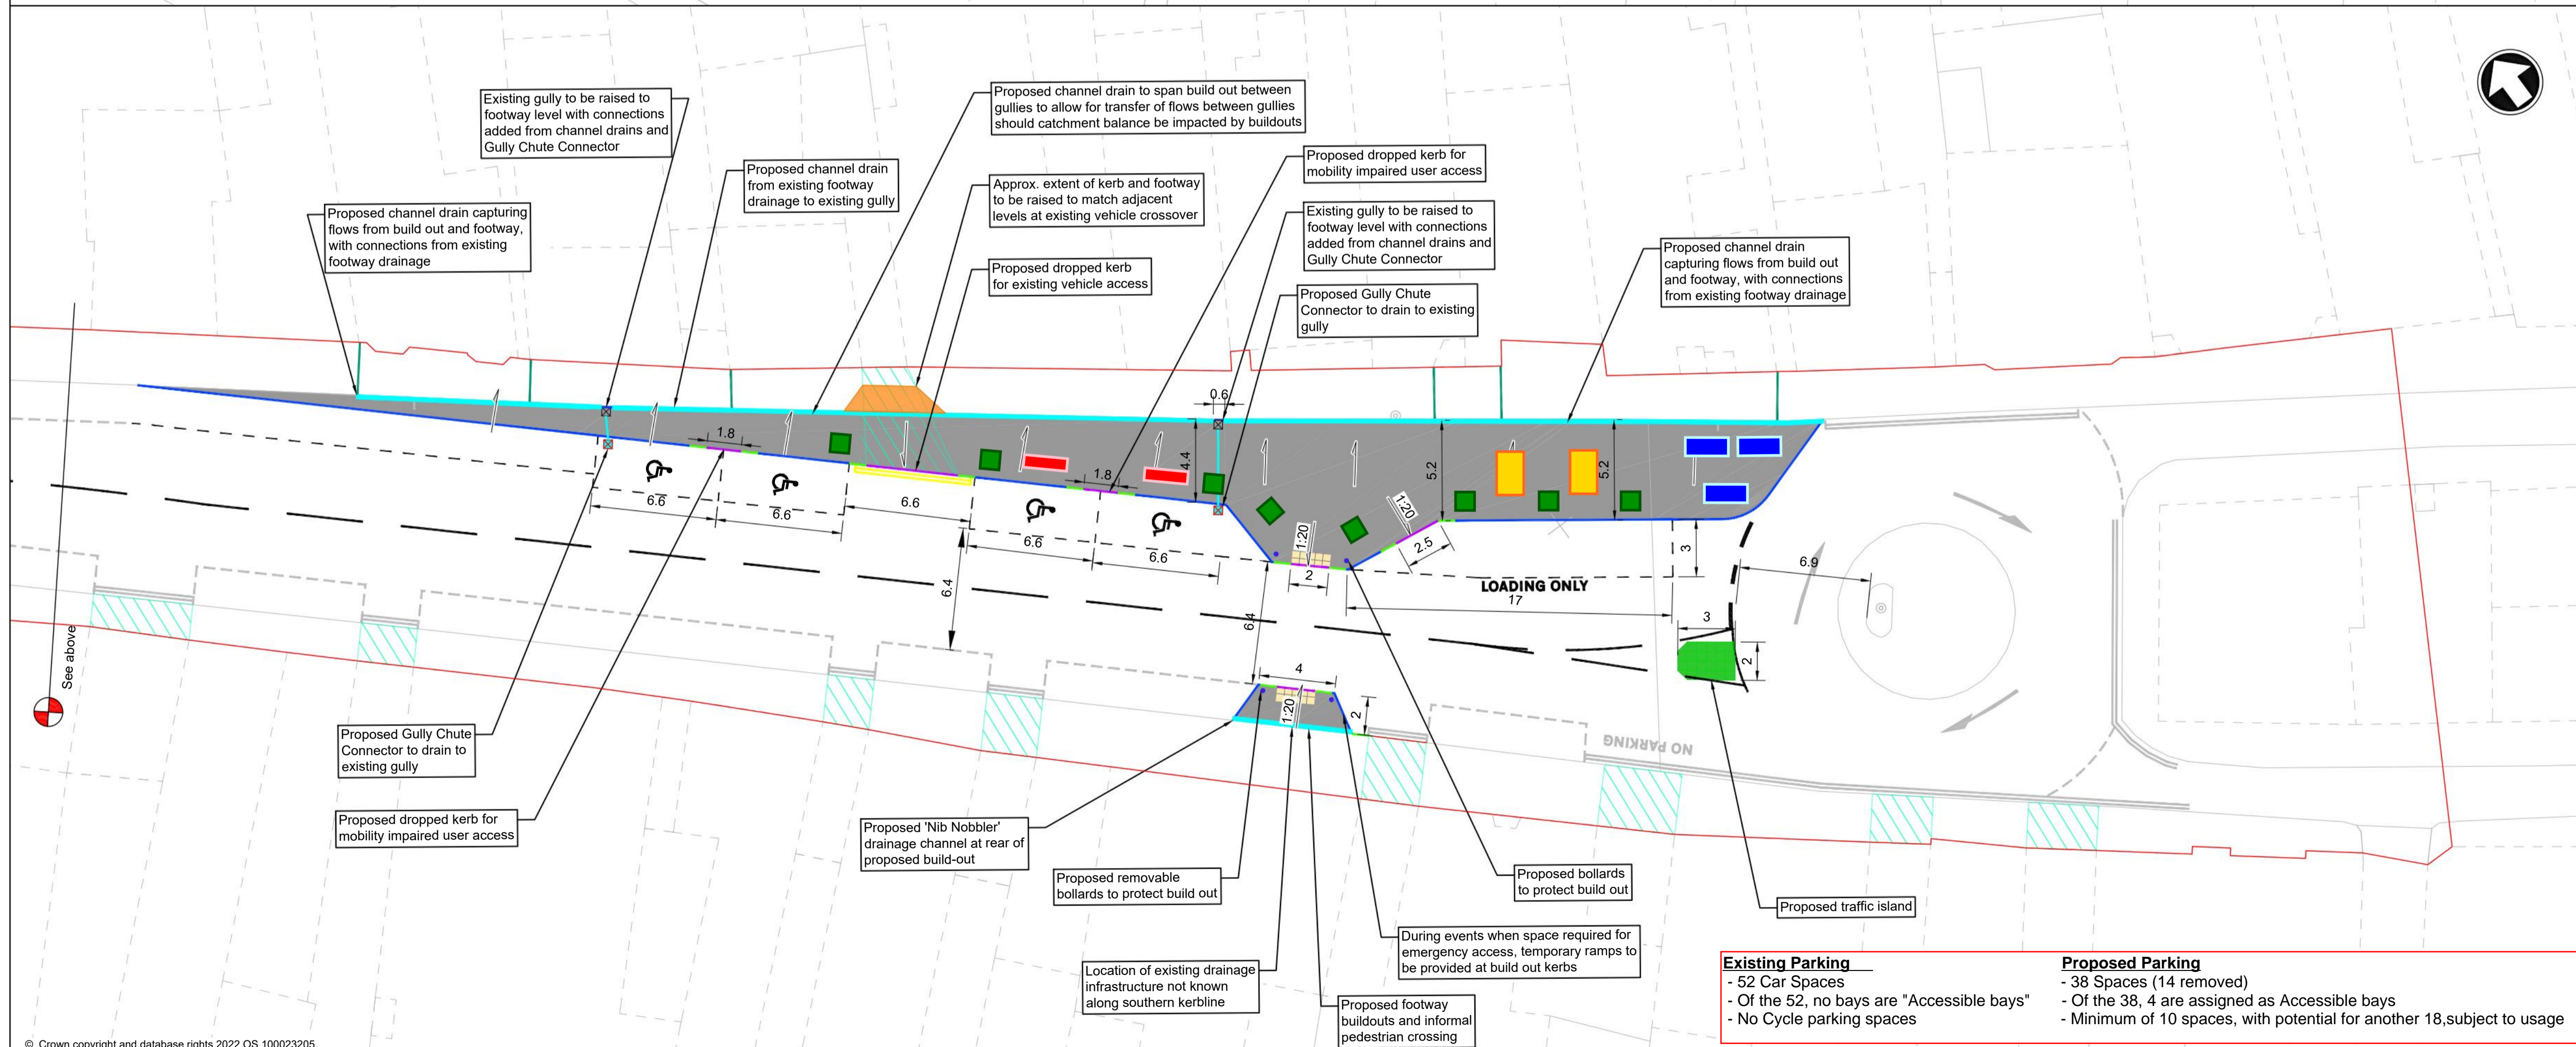

Existing Parking
 - 52 Car Spaces
 - Of the 52, no bays are "Accessible bays"
 - No Cycle parking spaces

Proposed Parking
 - 38 Spaces (14 removed)
 - Of the 38, 4 are assigned as Accessible bays
 - Minimum of 10 spaces, with potential for another 18, subject to usage

MOTT MACDONALD

Mott MacDonald
 22 Station Road
 Cambridge, CB1 2JD
 United Kingdom
 T +44 (0)1223 463 500
 F +44 (0)1223 461 007
 W mottmac.com



Title
 Cambridgeshire Active Travel
 The Broadway - H10
 General Arrangement

Designed	D. Richardson	DR	Eng check	C.Kwok	CK
Drawn	D. Richardson	DR	Coordination	C.Kwok	CK
Dwg check	C. Kwok	CK	Approved	O.Daffarn	OD
Scale at A1	Status	Rev	Security		
AS SHOWN	PRE	P7 Markup	STD		

Drawing Number
100100741-MMD-H10-XX-DR-C-0007